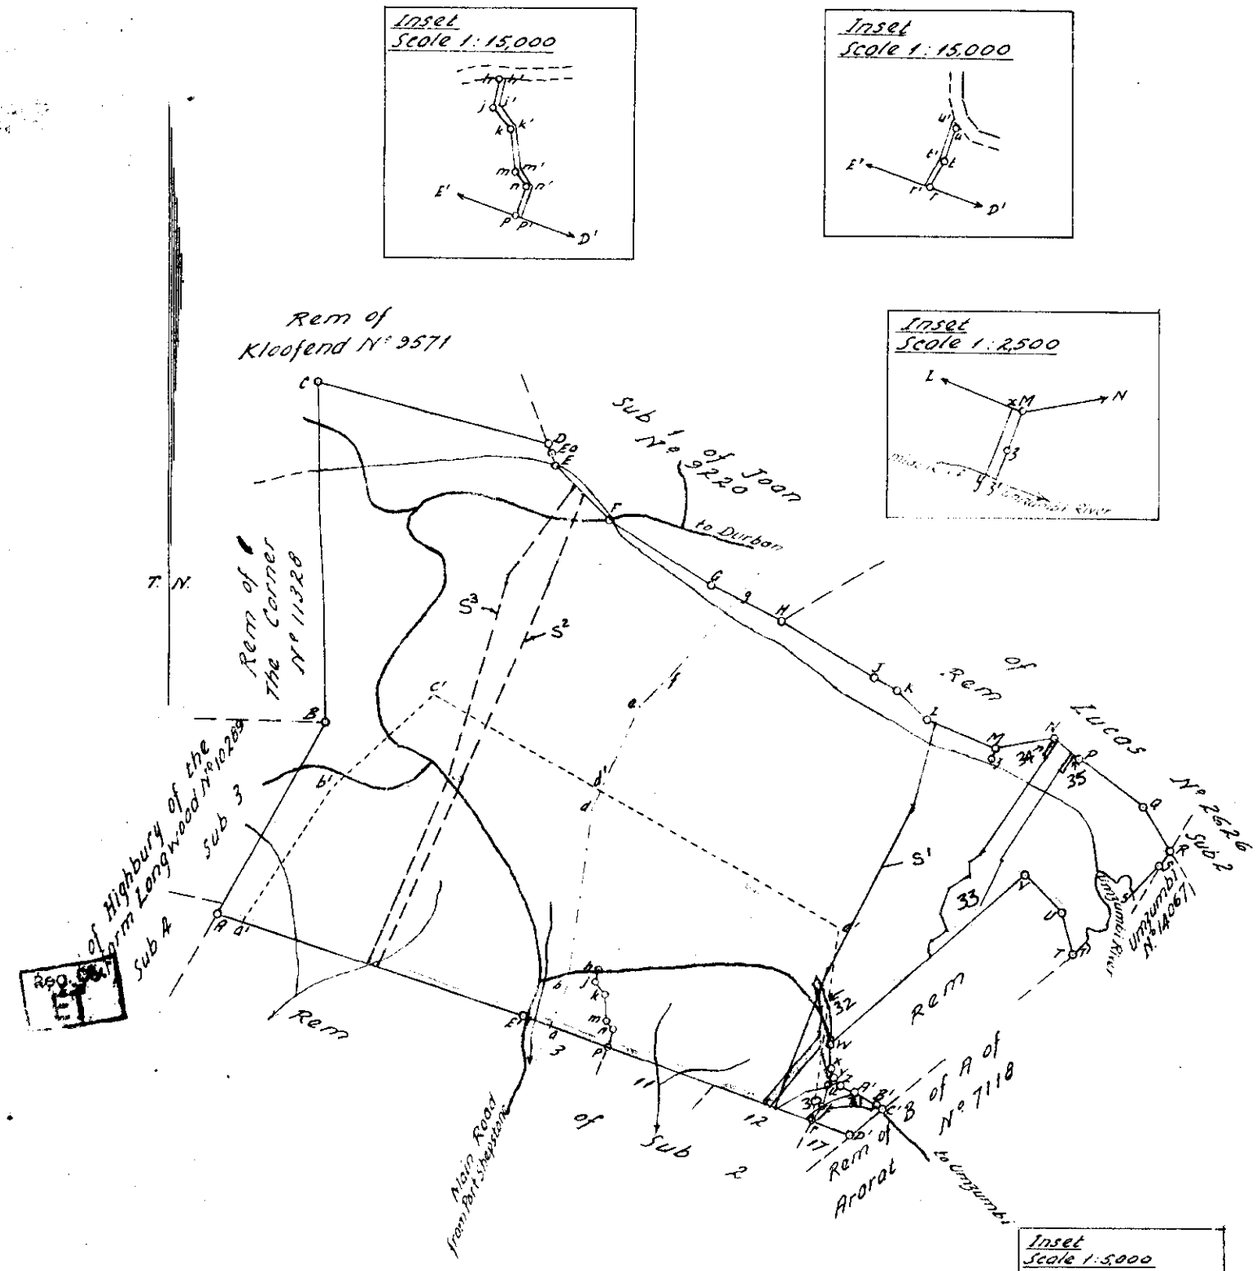

The line d'efg represents the middle line of an Electric Power Transmission Line Servitude 150' wide.
vide diagram S.G. N° 2423/54 and D/S 468/1955.

Beacons

A.E'.C.T. — . — . — . — . ⅜" round iron pegs in cairns.
B. — . — . — . — . — . ⅝" iron peg in cairn against wooden fence post.
D. — . — . — . — . — . sandstone cemented in cairn of stones.
E.R.Rb. — . — . — . — . not beaconed.
F. — . — . — . — . — . middle of west face of upright bridge stanchion being 95·8' from South abuttment.
G.J. — . — . — . — . 1½" iron pipes in cairns.
H. — . — . — . — . 1½" iron pipe in concrete cairn.
K.L.M.N.P.Q.S.V.Eo. } — ¾" iron bars.
W.X.Y.Z.A'.B'.C'.D'. }
Ro. — . — . — . — . — ¾" iron bar near monolith.
U. — . — . — . — . — ¾" iron bar in concrete.
h.j.k.m.n.t.u.z. — . — . ⅝" iron pegs.
p.r. — . — . — . — . ¾" iron pegs & stones.

Subs 32-35 vide
SG 4421-4426/
SR 1741 /1986

R ENDORSEMENTS, etc., SEE BACK

System Lo 31°

	SIDES English Feet	ANGLES OF DIRECTION			CO-ORDINATES Y	X	
					Const. +100,000·0	+11,100,000·0	
AB	2936·4	210. 11. 50		A	+ 53764·7	+ 13569·5	
BC	4527·3	178. 48. 00		B	+ 52287·8	+ 11031·6	
CD	3233·9	285. 10. 30		C	+ 52382·7	+ 6505·3	
DE	330·0	337. 16. 00		D	+ 49261·5	+ 7351·7	
EF	1044·9	316. 44. 40		E	+ 49134·0	+ 7656·1	
FG	1605·5	302. 21. 50		F	+ 48418·0	+ 8417·1	
GH	1071·4	296. 43. 50		G	+ 47061·9	+ 9276·5	
HJ	1394·8	300. 38. 50		H	+ 46105·0	+ 9758·4	
JK	407·8	300. 30. 00		J	+ 44905·0	+ 10469·4	
KL	537·8	318. 15. 50		K	+ 44553·6	+ 10676·4	
LM	1008·1	293. 21. 10		L	+ 44195·6	+ 11077·7	
MN	830·2	259. 48. 50		M	+ 43270·1	+ 11477·3	
NP	444·3	313. 59. 20		N	+ 42953·0	+ 11330·5	
PQ	1077·3	306. 54. 00		P	+ 42133·3	+ 11639·1	
QR	689·9	328. 34. 30		Q	+ 41271·8	+ 12285·9	
RS	263·5	34. 02. 50		R	+ 40912·1	+ 12874·6	
ST	1653·4	51. 28. 50		S	+ 41059·6	+ 13092·9	
TU	442·1	173. 54. 40		T	+ 42353·2	+ 14122·6	
UV	701·3	134. 32. 00		U	+ 42400·1	+ 12683·0	
VW	3437·0	49. 08. 50		V	+ 42900·0	+ 13191·2	
WX	287·7	0. 27. 30		W	+ 45499·7	+ 15439·3	
XY	129·0	342. 24. 30		X	+ 45502·0	+ 15727·0	
YZ	130·4	318. 43. 50		Y	+ 45463·0	+ 15850·0	
ZA'	202·1	288. 10. 00		Z	+ 45377·0	+ 15948·0	
A'B'	356·6	307. 28. 50		A'	+ 45185·0	+ 16011·0	
B'C'	60·4	291. 22. 40		B'	+ 44902·0	+ 16228·0	
C'D'	578·0	49. 31. 00		C'	+ 44845·8	+ 16250·0	
D'E'	4677·4	110. 45. 20		D'	+ 45285·4	+ 16625·3	
E'A	4337·1	108. 48. 30		E'	+ 49659·2	+ 14967·8	
SS'		51. 28. 50					
TT'		231. 28. 50					
	Servitude Data						
E'h	1226·2	238. 43. 50					
hj	208·6	15. 01. 50		h	+ 48611·1	+ 14331·3	
jk	232·3	327. 58. 10		j	+ 48665·2	+ 14532·8	
km	334·6	349. 29. 40		k	+ 48542·0	+ 14729·7	
mn	113·2	331. 26. 30		m	+ 48481·0	+ 15059·7	
nP	258·7	20. 27. 10		n	+ 48426·9	+ 15158·1	
PE'	1221·1	110. 45. 10		p	+ 48517·3	+ 15400·5	
	Servitude Data						
D'r	565·0	110. 45. 20					
rt	267·9	217. 41. 30		r	+ 45813·7	+ 15425·1	
tu	286·0	~~199. 39. 20~~		t	+ 45649·9	+ 16213·1	L.L.
uD'	791·4	338. 36. 50		u	+ 45552·1	+ 15944·3	
	Servitude Data						
MZ	54·9	13. 51. 10			43283·2	11530·5	
ZP	1155·0	275. 23. 40		Z	+ ~~42133·3~~	+ ~~11639·1~~	L.L.
	Indicatory Beacons						
RoR	55·0	34. 03. 40		Ro	+ 40881·3	+ 12829·0	
EoE	187·9	337. 16. 00		Eo	+ 49206·6	+ ~~15482·8~~	

The figures h.j.k.m.n.p.p.n.m.k.j.h. and u.t.r.r.i.u' represent Right of Way Servitudes 30' wide.

~~The figure M.Z.I.y.E represents a Right of Way Servitude 15' wide.~~ middle of Umzumbi River

The line abcdefg represents the middle line of an Electric Power Transmission Line Servitude 150' wide.
vide diagram S.G. N° 2424/54 and D/S 468/1955.

SCALE 1 : 25000

S. G. No. 557/57

Approved

Surveyor General. 20 · 9 · 1957.

ESTABLISHED Beacons	ESTABLISHED Boundaries	Plan No. S.R. No.
H.J.	H-J.	16/1937
J-R.	J.R.	284/1937
		10/1957
		1182/1956
		88/1957

NEW SUB 1 OF THE Fairview No 5590

The figure A·B·C·D·E·F·G·H·J·K·L·M·N·P·Q·R·S·S'·High Water Mark Umzumbi River·T'·T·U·V·W·X·Y·Z·A'·B'·C'·D'·E'

represents 1459·3771 Acres of land being

the Sub 1 of Consolidated Farm Fairview N° 7915 ZL

situate in the County of Alexandra, Province of Natal.

Surveyed in June and July 1950 and August - November 1956, by me and in March 1951, by me and in September - October 1956, by me

Land Surveyor.

This diagram relates to C.R.T. No. 437/58 Registrar of Deeds.

The original diagram is S.G. No. 372/57 relating to ~~Deed~~ Cert. of Amended Title on Consolidation No.

File No. 21/21
Survey Records 88/1957
Compilation
Degree Sheet 66
Tracing
General Plan ETSH ETSC

COM. ETSA

PRINTED BY TARBOTON & MITCHELL, P.O. BOX 501, P.M.BURG 5579-10-55